
Исполнительная схема 31,07,2024

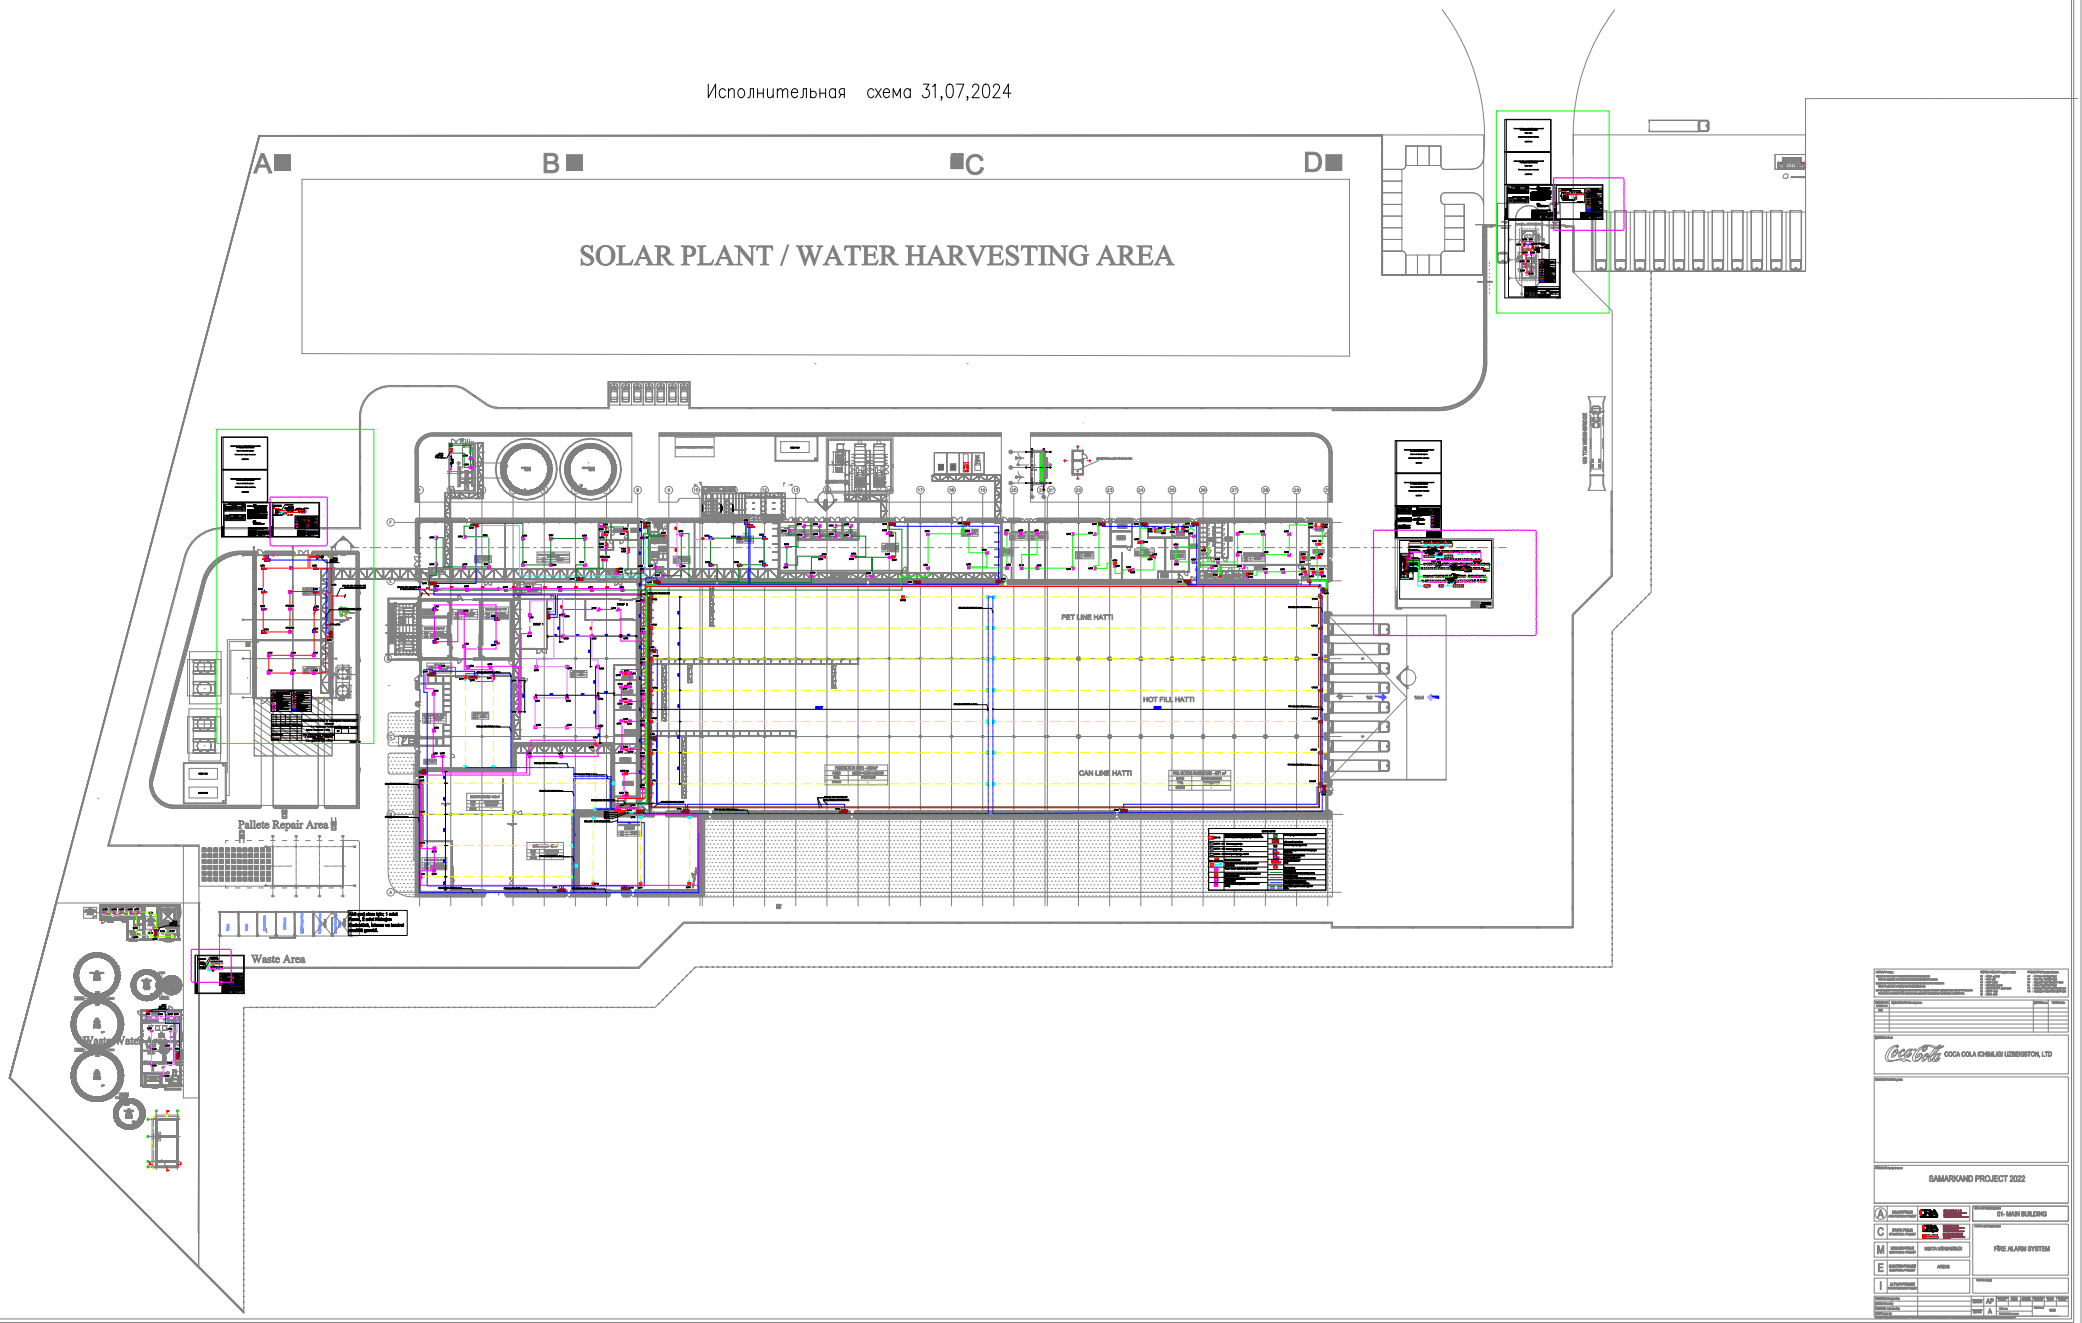

COCA COLA ICHIMLIGI UZBEKISTON, LTD

SAMARKAND PROJECT 2022

01- MAIN BUILDING

FIRE ALARM SYSTEM